

GENERAL SHEET NOTES

1. ALL DIMENSIONS AT WALLS ARE TO FACE OF FRAME UNLESS OTHERWISE NOTED
2. ALL OPENINGS DIMENSIONED AT CENTER LINES UNLESS OTHERWISE NOTED.
3. SEE S-101 FOR GRID LINES DIMENSIONS.
4. CELLULOSE INSULATION WITHIN WALL PANELS
5. DENIM BAT INSULATION BETWEEN PANELS



MIDDLEBURY COLLEGE

TEAM NAME: TEAM MIDDLEBURY
ADDRESS: 14 OLD CHAPEL ROAD
 MIDDLEBURY, VT 05753
CONTACT: MIDDSD@MIDDLEBURY.EDU
 SD13.MIDDLEBURY.EDU

CONSULTANTS

ARCHITECTURE
 A. MURRAY, A. NELSON
 vermontintegratedarchitecture.com
ENGINEERING
 G. SELLERS

CLIENT

U.S. DEPARTMENT OF ENERGY
 SOLAR DECATHLON 2013
 WWW.SOLARDECATHLON.GOV



MARK	DATE	DESCRIPTION
I	10/11/2012	80% COMPLETE SUBMISSION
II	2/14/2013	100% CONSTRUCTION DOCUMENTATION
III	8/22/2013	AS BUILT DOCUMENTATION


MARK	DATE	DESCRIPTION

LOT NUMBER: 110
DRAWN BY: TEAM INSITE
CHECKED BY: TEAM INSITE
COPYRIGHT: NONE: PROJECT IS PUBLIC DOMAIN

SHEET TITLE

FLOOR PLAN

A-111

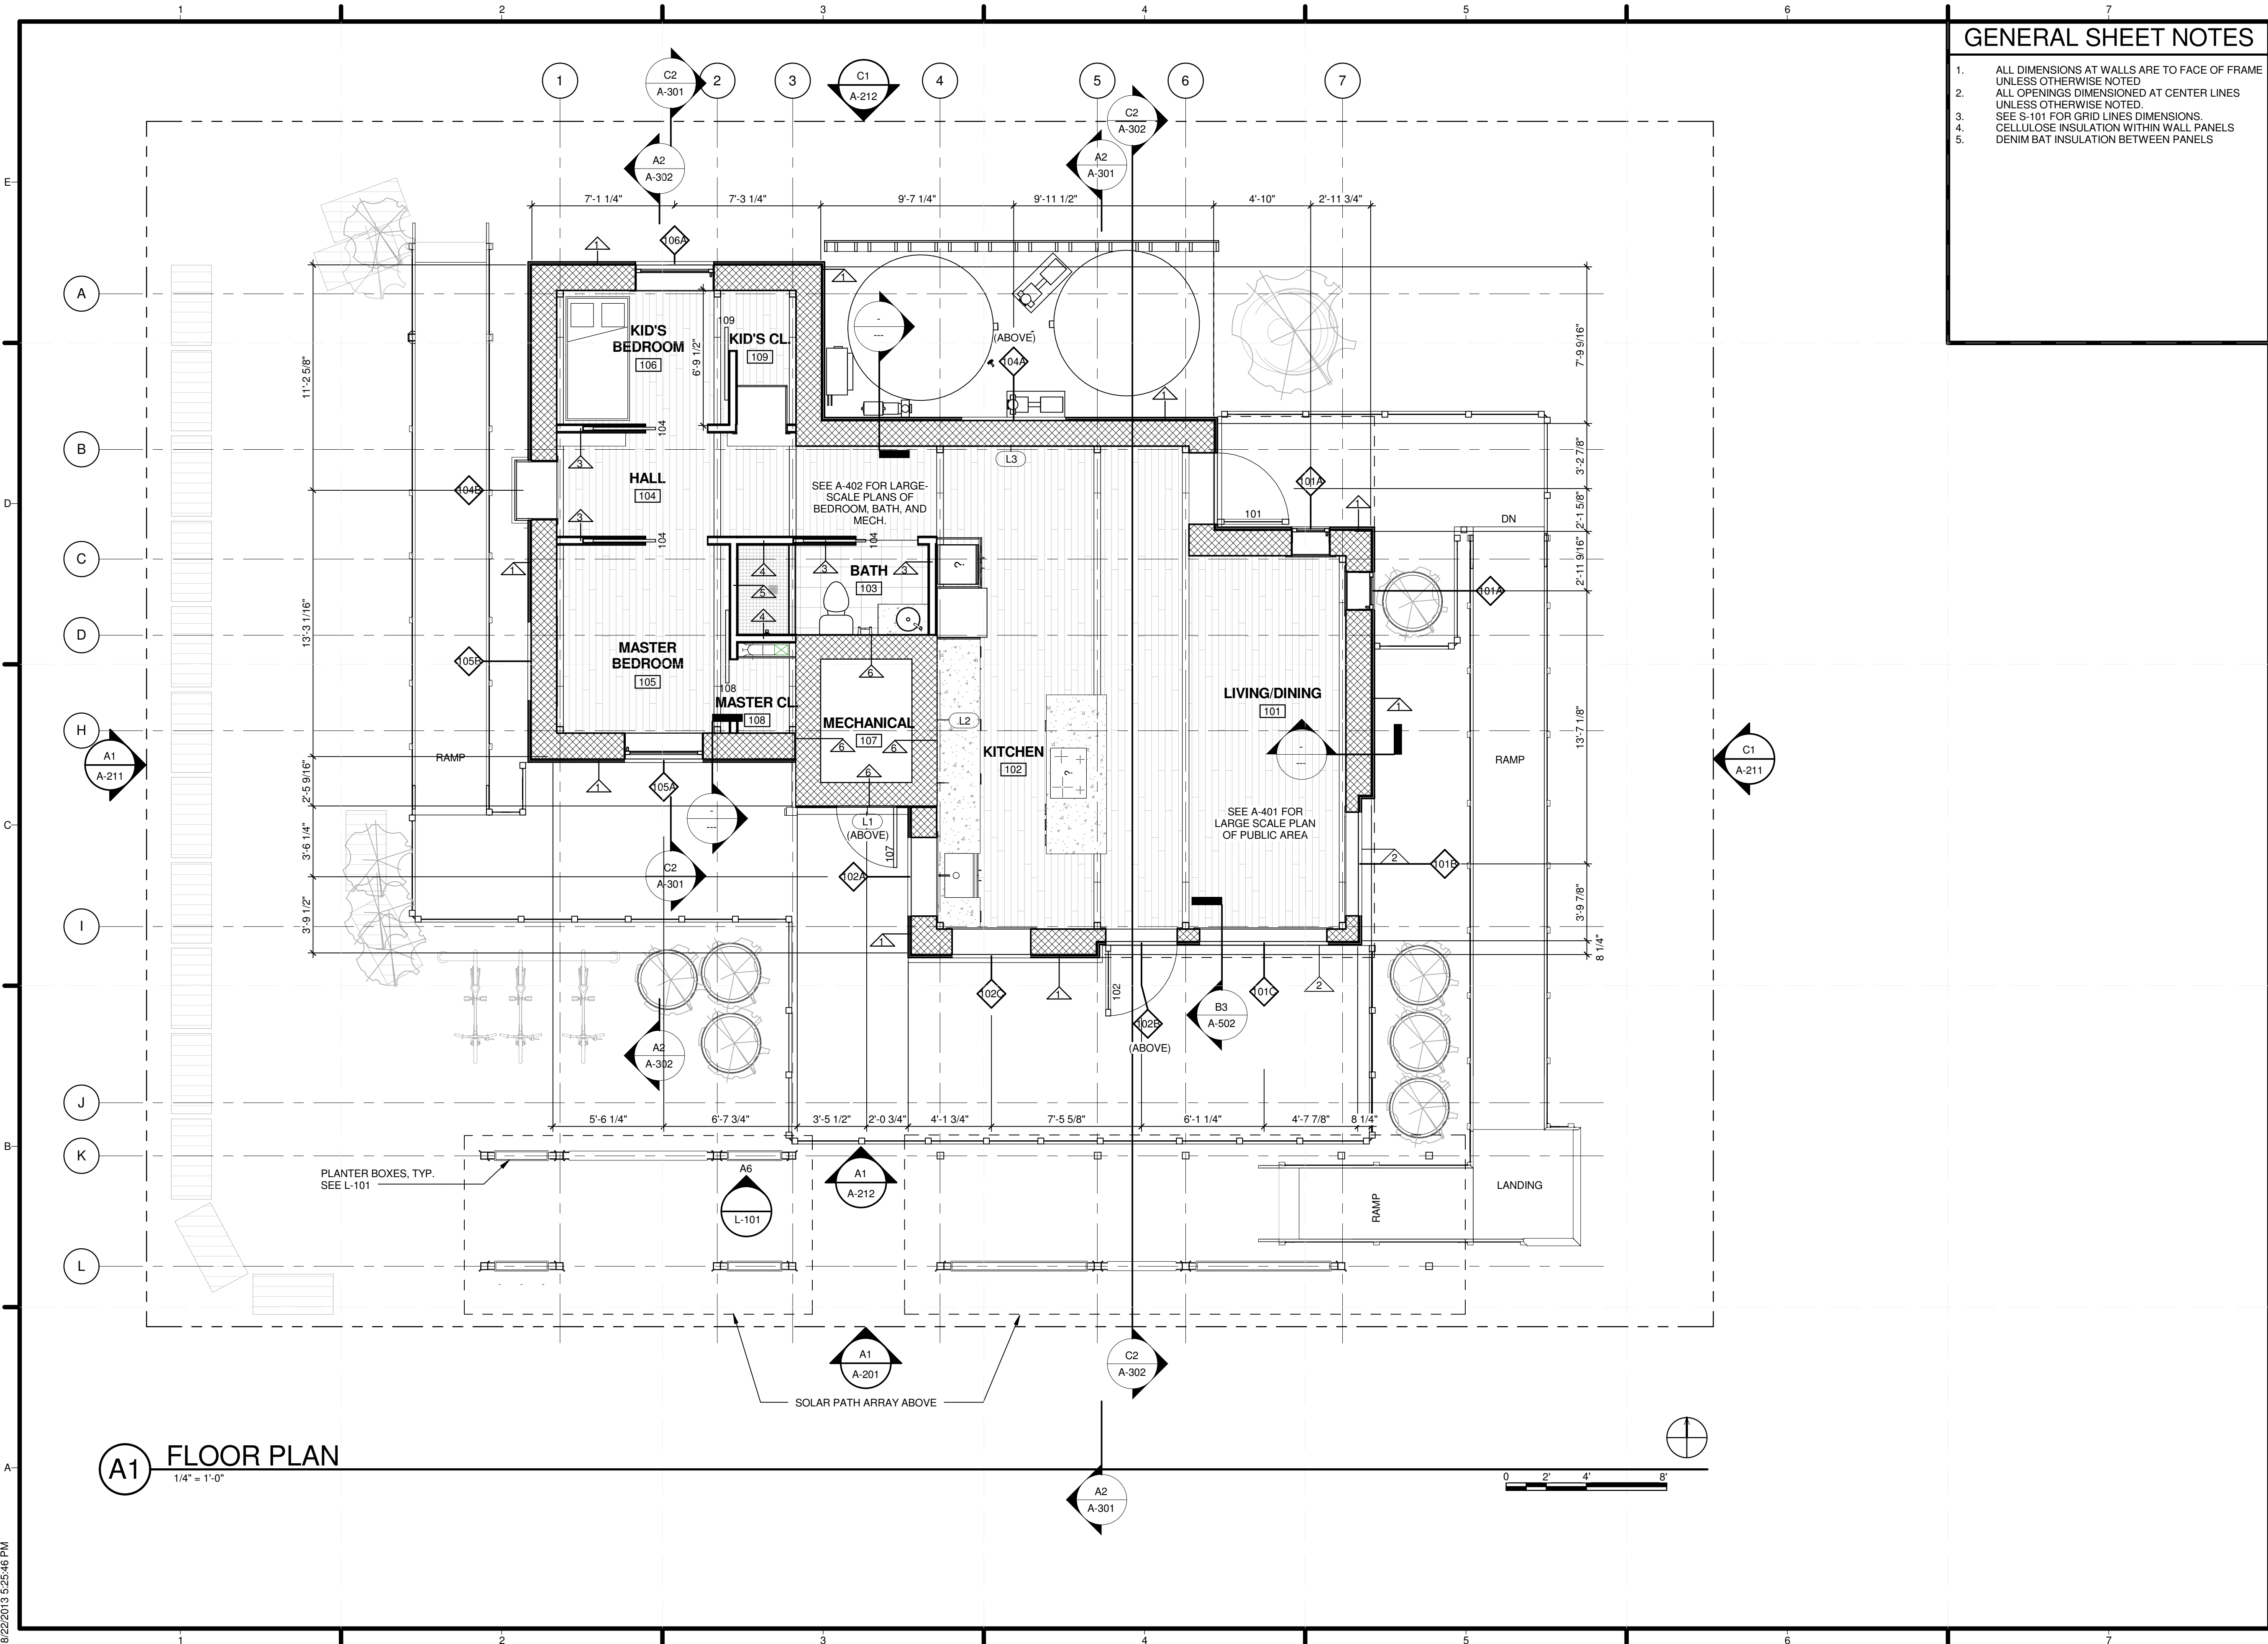

A1 FLOOR PLAN
 1/4" = 1'-0"