



ECOHABIT
STEVENS SOLAR DECATHLON 2013

TEAM NAME
STEVENS INSTITUTE

ADDRESS
ECOHABIT HOUSE
1 CASTLE POINT ON HUDSON
HOBOKEN, NJ 07030

CONTACT
SOLARDECATHLON@STEVENS.EDU
WWW.STEVENS.EDU/SD2013

CONSULTANTS

ARCHITECT OF RECORD
NASTASI ARCHITECTS
321 NEWARK STREET
HOBOKEN, NJ 07030
(P) (201) 653-2577
(F) (201) 698-0920

STRUCTURAL ENGINEER OF RECORD
CRAFT ENGINEERING STUDIO
CONSULTING STRUCTURAL ENGINEERS
350 ALBANY ST, SUITE 15D
NEW YORK, NY 10280
(P) (646) 912-9867

MEP CONSULTING ENGINEERS
BURO HAPPOLD CONSULTING ENGINEERS P.C.
100 BROADWAY
NEW YORK, NY 10005
(P) (212) 334-2025
(F) (212) 334-5528

CLIENT
US DEPARTMENT OF ENERGY
SOLAR DECATHLON 2013
WWW.SOLARDECATHLON.GOV



MARK	DATE	DESCRIPTION
1	OCT. 11, 2012	DESIGN DEVELOPMENT
2	NOV 26, 2012	DD RESUBMISSION
3	FEB 14, 2013	CONSTRUCTION DOCUMENTS
4	APR 5, 2013	CD RESUBMISSION
5	AUG 22, 2013	AS-BUILT SUBMISSION

LOT NUMBER
102


DRAWN BY
AUTHOR

CHECKED BY
MWP

COPYRIGHT
NONE: PROJECT IS PUBLIC DOMAIN

SHEET TITLE
FIRST FLOOR PLAN

A-111

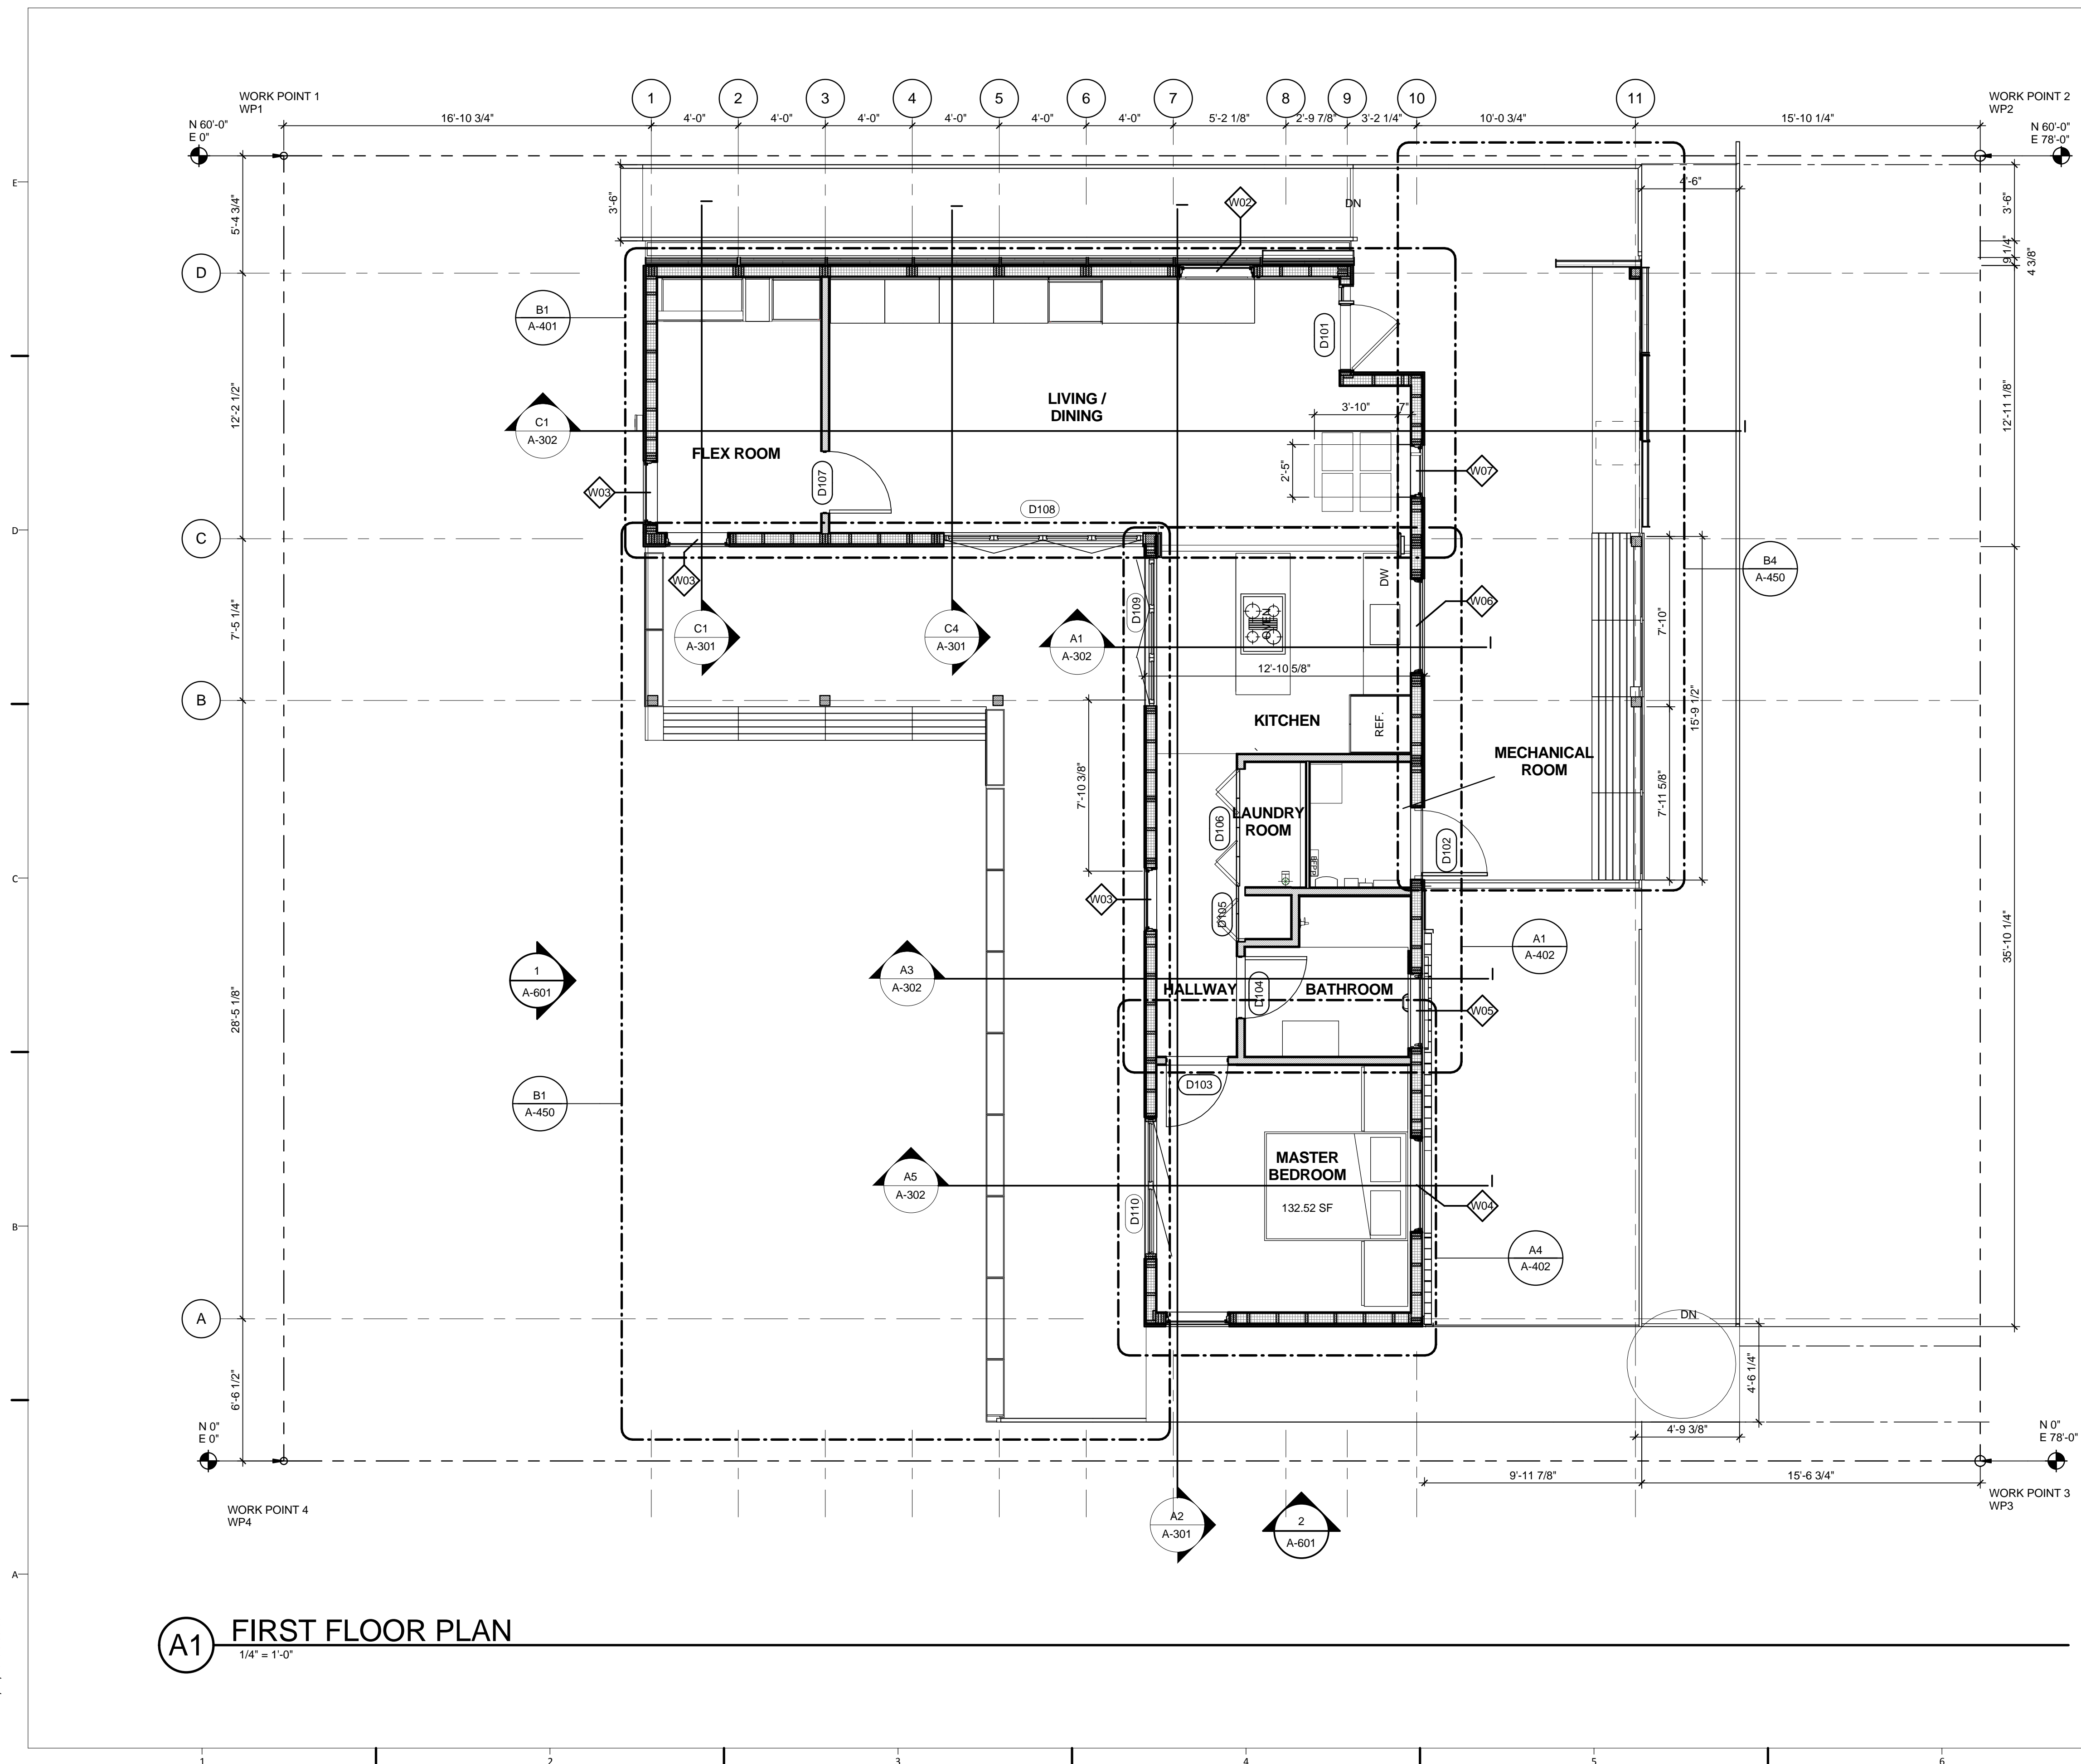

A1 FIRST FLOOR PLAN

1/4" = 1'-0"



8/22/2013 5:53:00 PM