
## PRODUCED BY AN AUTODESK STUDENT VERSION

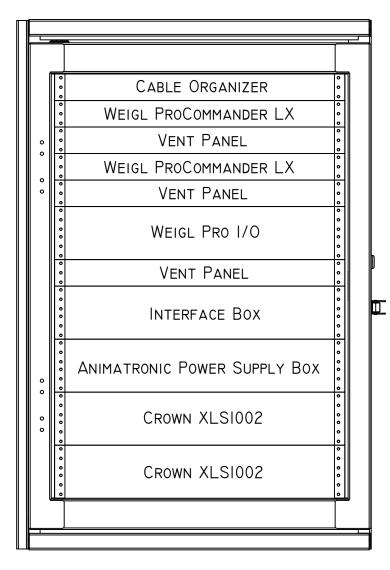

NEW YC	RK CITY COLLEGE	OF TE	CHNOLOGY
NYCCT			
	RACK LAYOUT		Plate No.
	FRONT ELEVATION		] <]
SCALE:	NTS		] []
Date:	7/11/19		
Drafter:	PHOENIXX NEIL		OF: 1

PRODUCED BY AN AUTODESK STUDENT VERSION